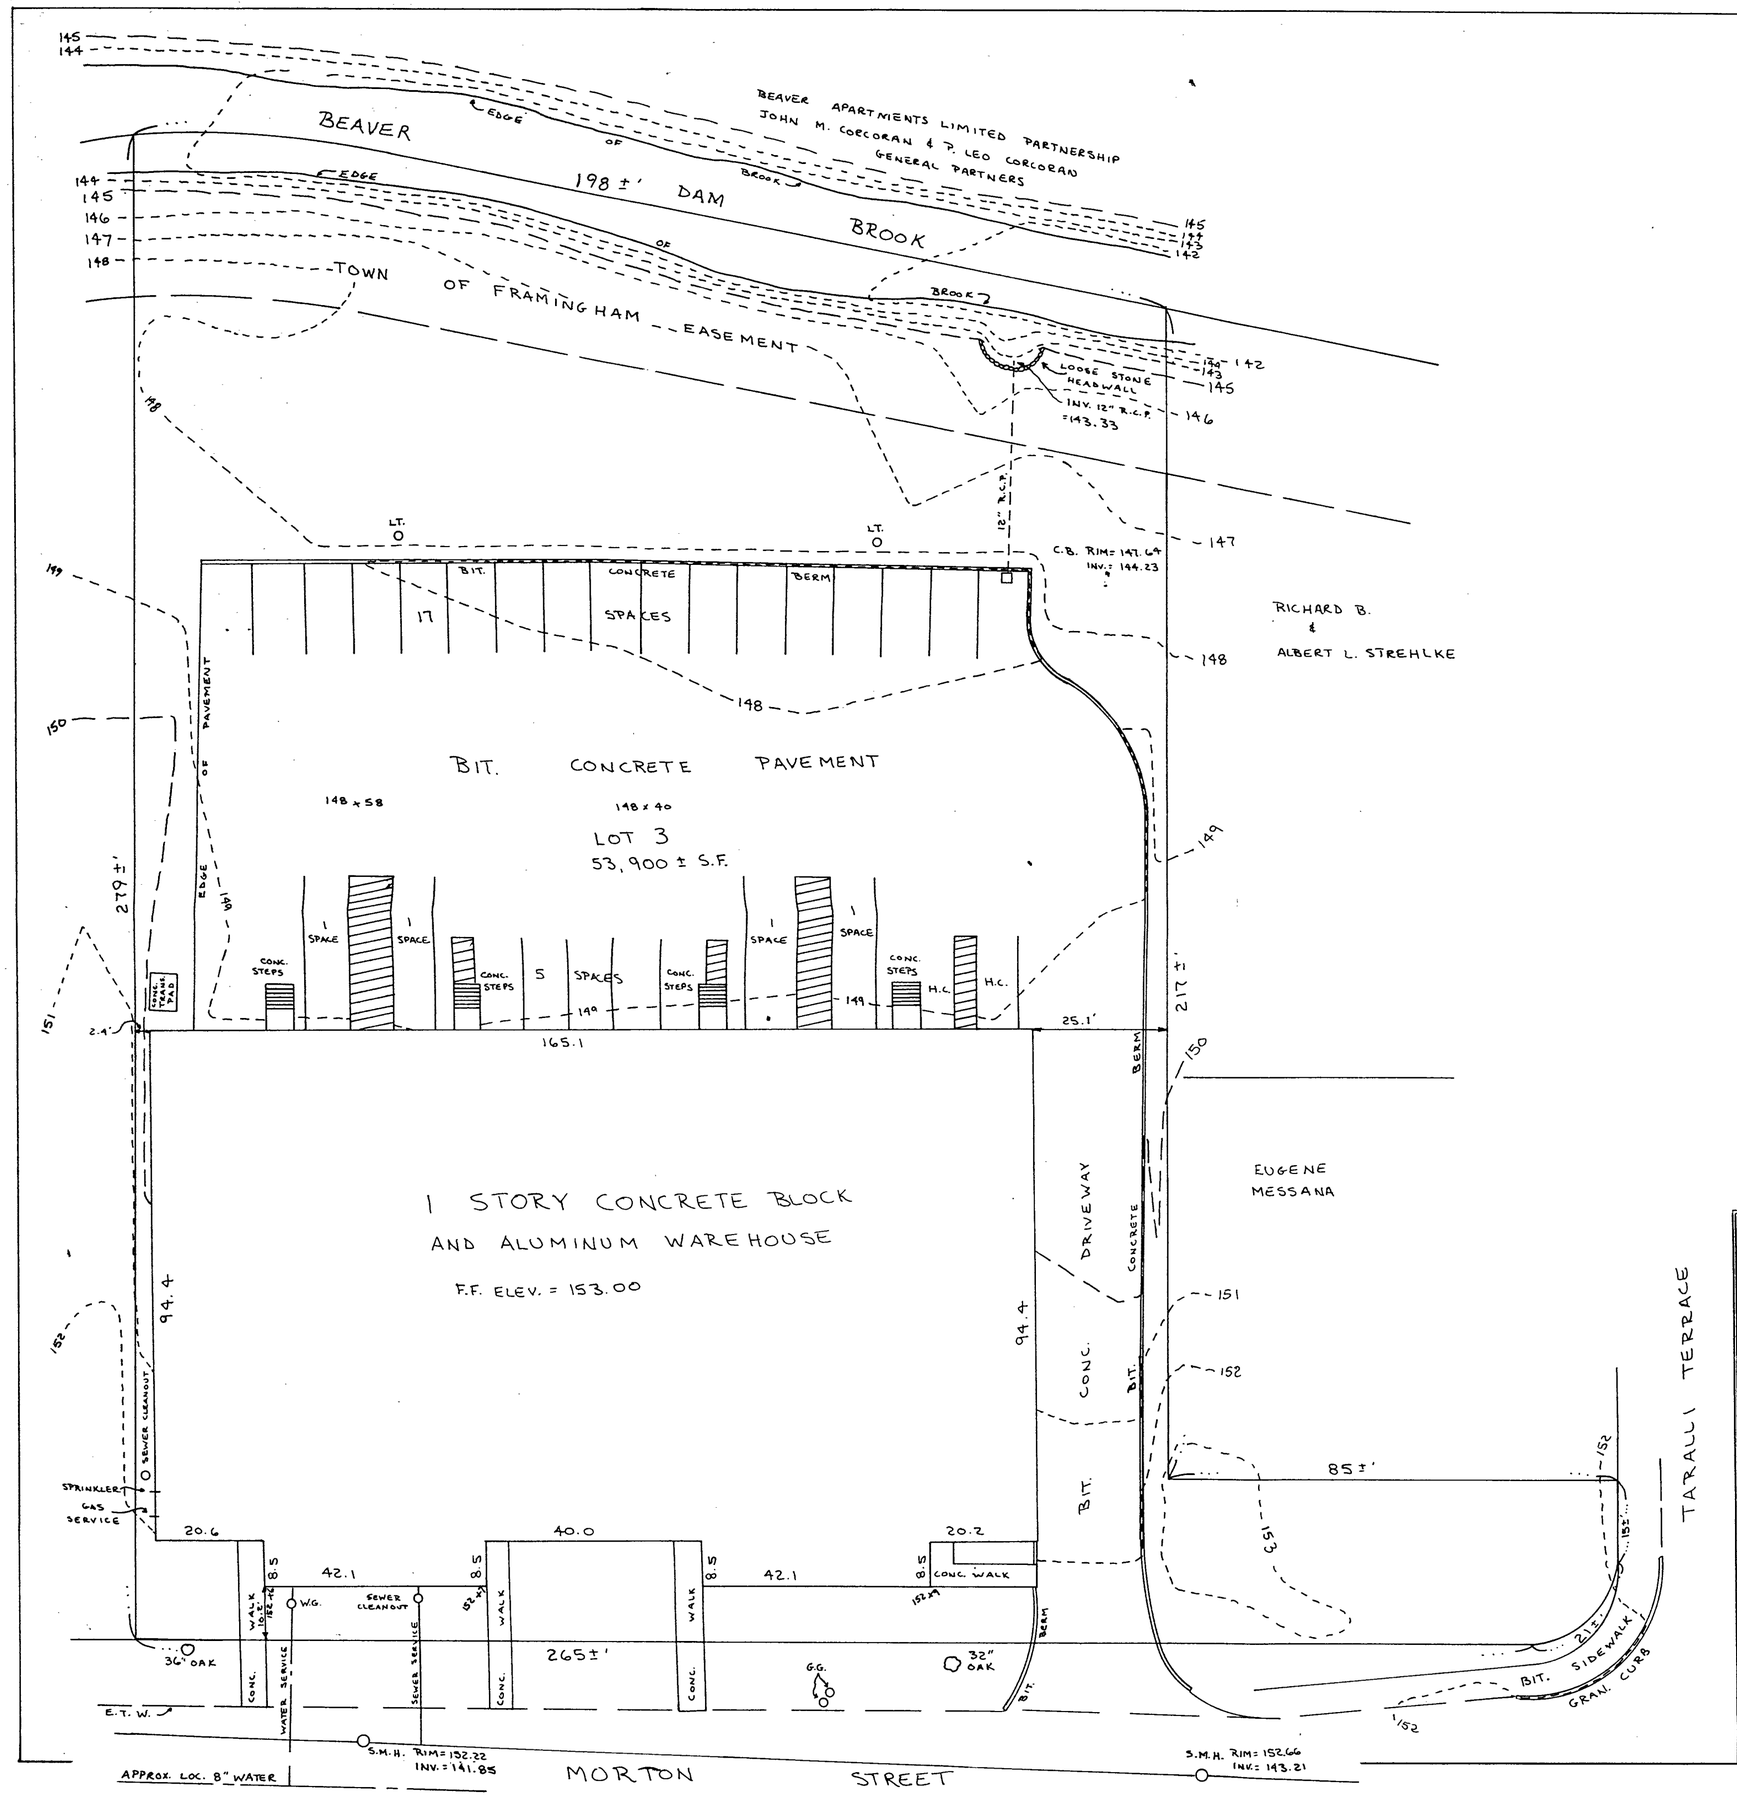

NOTE: ROOF DRAIN DOWNSPOUTS ARE PROVIDED AT 4 CORNERS OF BUILDING

NOTE: PARKING SPACES PROVIDED
22 REGULAR SPACES
4 LOADING SPACES
2 HANDICAPPED SPACES

AS BUILT PLAN OF LAND IN

FRAMINGHAM, MASS.

APPLICANT : WAYNE L. HANSEN
64 WAVERLY ST. FRAMINGHAM

SCALE : 1" =20'

DECEMBER 31, 1986

COMMONWEALTH OF MASSACHUSETTS
JOSEPH R. SULLIVAN
No 18846
REGISTERED LAND SURVEYOR

JOSEPH R. SULLIVAN
REG. PROF. LAND SURVEYOR

MacCARTHY & SULLIVAN ENGINEERING INC.
81 SPEEN STREET NATICK, MASSACHUSETTS

DESIGN BY :	DRAWN BY :	CHKD. BY :	DWG. NO. 26,348 A
—	P.J.C.	P.J.S.	

26,348 A

26,348 A

BEAVER APARTMENTS LIMITED PARTNERSHIP
JOHN M. CORCORAN & P. LEO CORCORAN
GENERAL PARTNERS

BEAVER DAM BROOK

198 ± '

EDGE OF BROOK

TOWN OF FRAMINGHAM EASEMENT

LOOSE STONE HEADWALL
INV. 12" R.C.P. = 143.33

12" R.C.P.

C.B. RIM = 147.64
INV. = 144.23

RICHARD B.
&
ALBERT L. STREHLKE

BIT. CONCRETE PAVEMENT

148 x 58

148 x 40

LOT 3
53,900 ± S.F.

17 SPACES

5 SPACES

1 SPACE

CONC. STEPS

H.C.

EDGE OF PAVEMENT

279 ±'

217 ±'

165.1

25.1'

1 STORY CONCRETE BLOCK
AND ALUMINUM WAREHOUSE

F.F. ELEV. = 153.00

94.4

CONC. DRIVEWAY

BIT.

BERM

EUGENE
MESSANA

TARALLI TERRACE

85 ±'

BIT. SIDEWALK

GRAN. CURB

SEWER CLEANOUT

SPRINKLER
GAS
SERVICE

20.6

42.1

8.5

40.0

20.2

CONC. WALK

WALK

CONC.

W.G.

SEWER CLEANOUT

SEWER SERVICE

WATER SERVICE

265 ±'

36" OAK

32" OAK

G.G.

E.T.W.

S.M.H. RIM = 152.22
INV. = 141.85

S.M.H. RIM = 152.66
INV. = 143.21

APPROX. LOC. 8" WATER

MORTON STREET

NOTE: ROOF DRAIN DOWNSPOUTS ARE PROVIDED AT 4 CORNERS OF BUILDING

NOTE: PARKING SPACES PROVIDED
22 REGULAR SPACES
4 LOADING SPACES
2 HANDICAPPED SPACES

AS BUILT PLAN OF LAND IN

FRAMINGHAM, MASS.

APPLICANT : WAYNE L. HANSEN
64 WAVERLY ST. FRAMINGHAM

SCALE : 1" = 20'

DECEMBER 31, 1986

COMMONWEALTH OF MASSACHUSETTS
JOSEPH R. SULLIVAN
No 18846
REGISTERED LAND SURVEYOR

JOSEPH R. SULLIVAN
REG. PROF. LAND SURVEYOR

MacCARTHY & SULLIVAN ENGINEERING INC.
81 SPEEN STREET
NATICK, MASSACHUSETTS

DESIGN BY :	DRAWN BY :	CHKD. BY :	DWG. NO. 26,348 A
—	P.J.C.	P.J.S.	

26,348

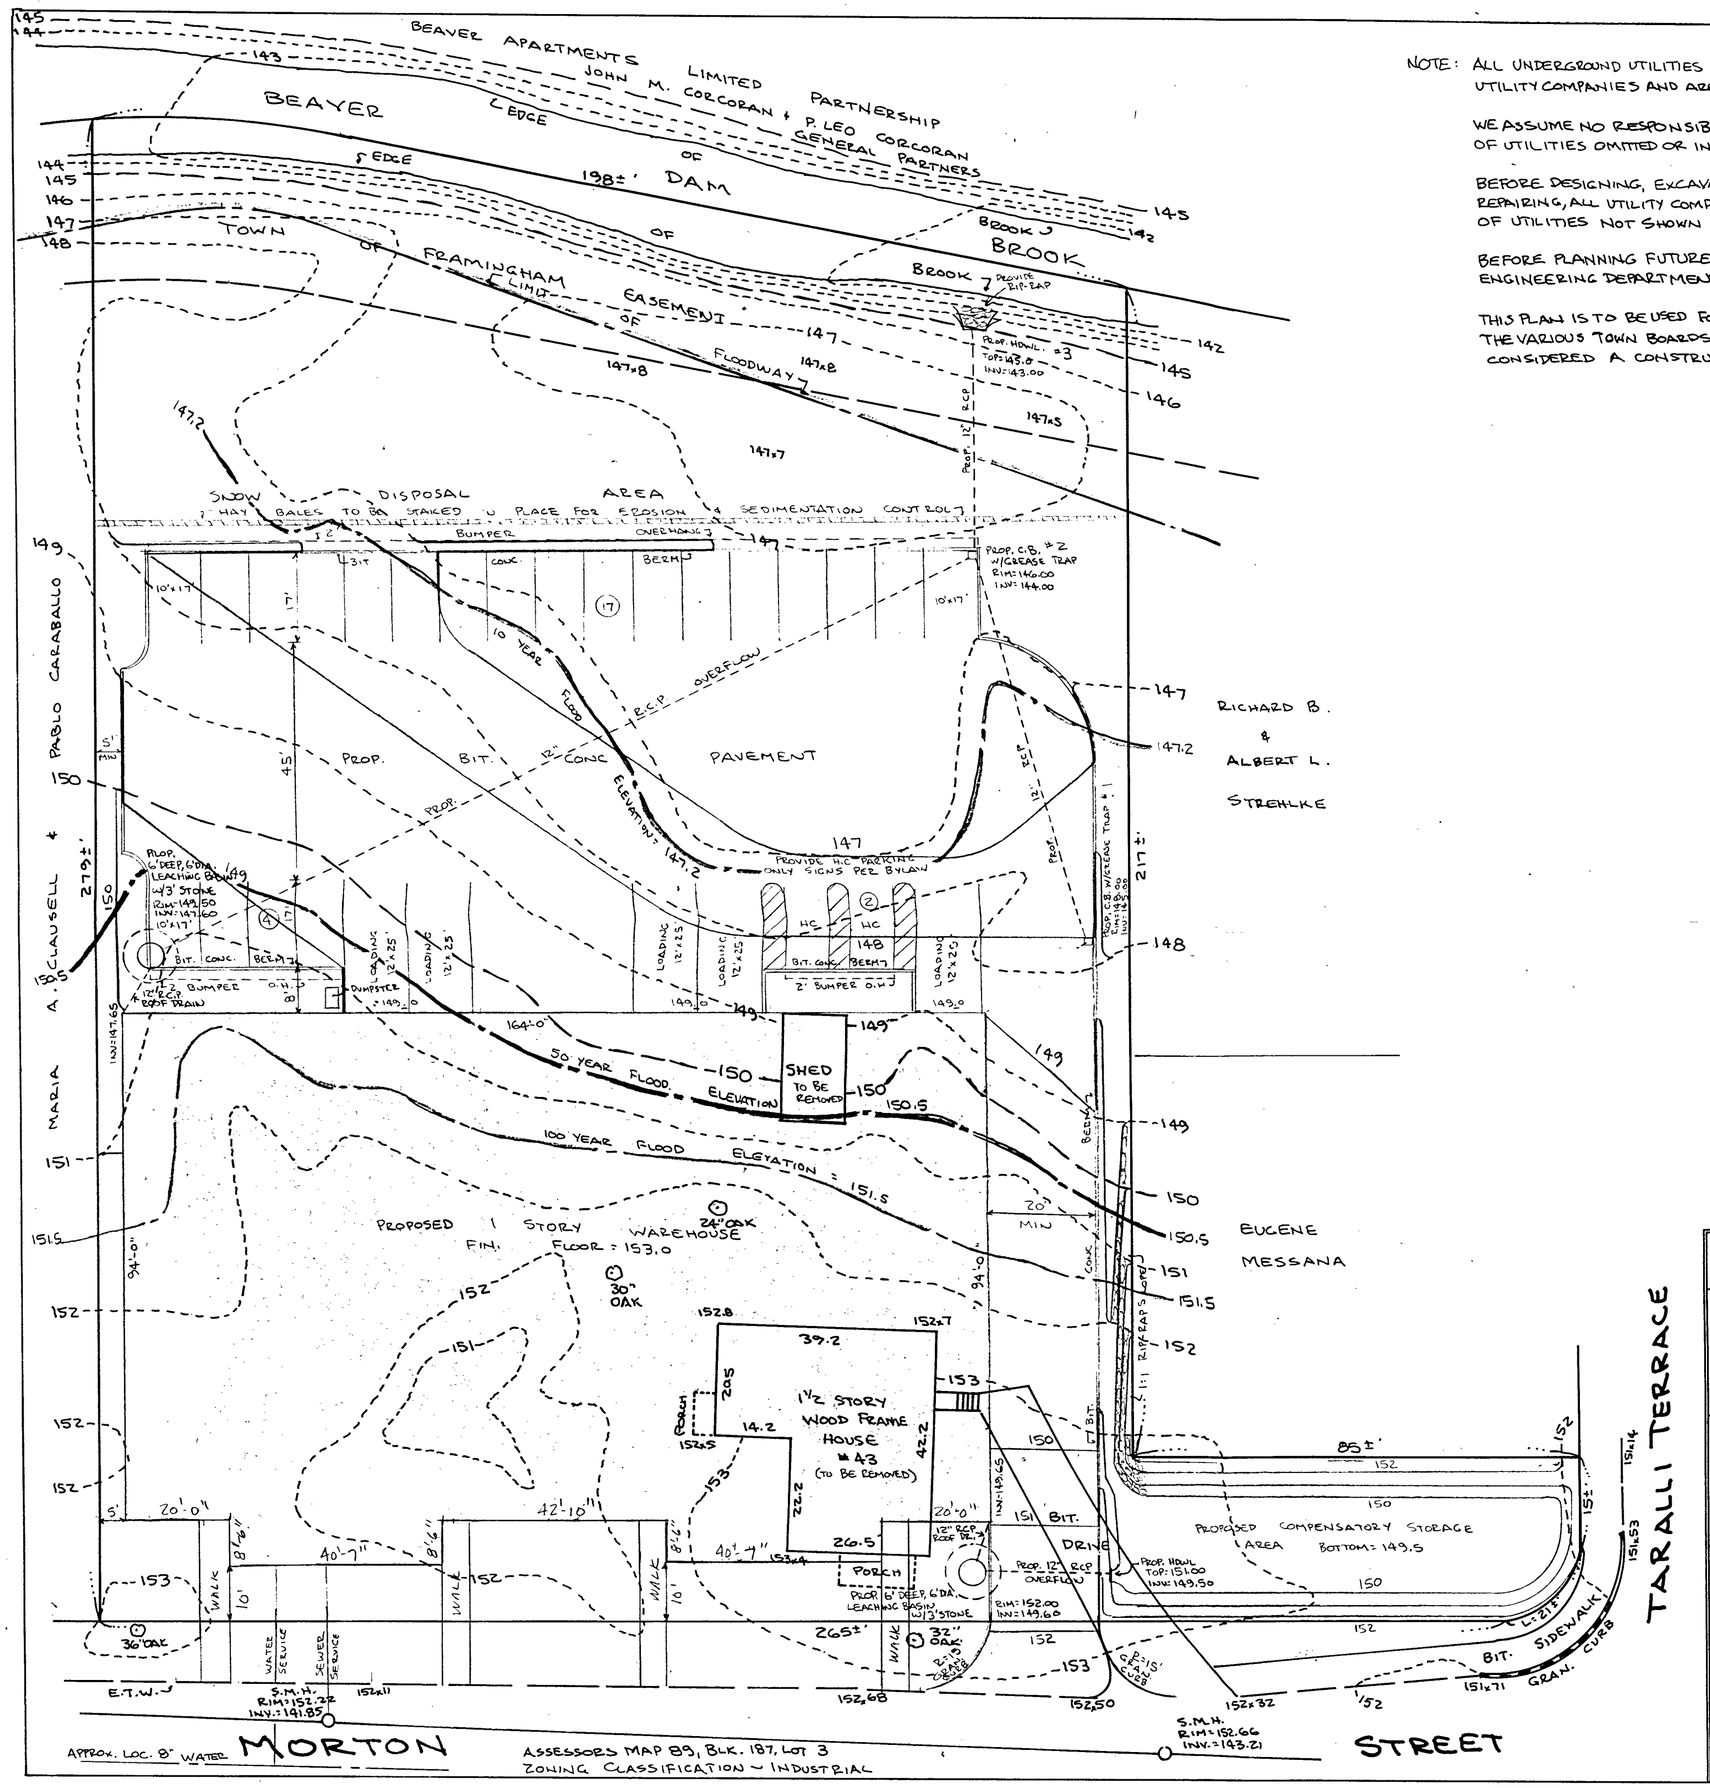

NOTE: ALL UNDERGROUND UTILITIES SHOWN WERE COMPILED ACCORDING TO AVAILABLE RECORDS FROM THE VARIOUS UTILITY COMPANIES AND ARE APPROXIMATE ONLY. ACTUAL LOCATIONS MUST BE MADE IN THE FIELD.

WE ASSUME NO RESPONSIBILITY FOR DAMAGES INCURRED AS A RESULT OF UTILITIES OMITTED OR INACCURATELY SHOWN.

BEFORE DESIGNING, EXCAVATING, BLASTING, INSTALLING, BACKFILLING, GRADING, PAVEMENT RESTORATION OR REPAIRING, ALL UTILITY COMPANIES, PUBLIC AND PRIVATE, MUST BE CONTACTED INCLUDING THOSE IN CONTROL OF UTILITIES NOT SHOWN ON THIS PLAN. SEE CHAPTER 370, ACTS OF 1963, MASS.

BEFORE PLANNING FUTURE CONNECTIONS, THE APPROPRIATE PUBLIC UTILITY ENGINEERING DEPARTMENT MUST BE CONSULTED.

THIS PLAN IS TO BE USED FOR OBTAINING APPROVAL FROM THE VARIOUS TOWN BOARDS ONLY AND IS NOT TO BE CONSIDERED A CONSTRUCTION PLAN.

AREA OF LOT = 53,900± SQ. FT.
AREA OF BUILDING = 16,105 SQ. FT.
% BUILDING COVERAGE = 29.9%
ALLOWABLE FLOOR AREA = 26,950 SQ. FT.
GROSS FLOOR AREA = 16,105 SQ. FT.
MAX. NO. OF EMPLOYEES AT ONE TIME = 15
PARKING REQUIRED = 15 SPACES
PARKING PROVIDED = 23 SPACES
TYPICAL PARKING SPACE SIZE:
9'x19' & 10'x19' WHERE END STALLS RESTRICTED BY CURBING
MINIMUM DRIVEWAY WIDTH = 20'
AREA OF PARKING AREA: 15,700± SQ. FT.
OPEN SPACE REQUIRED BY PARKING BYLAW = 1570 SQ. FT.
OPEN SPACE REQUIRED BY ZONING BYLAW = 1610 SQ. FT.
OPEN SPACE PROVIDED = 21,500± SQ. FT.
TREES REQUIRED = 2
TREES PROVIDED = 2 EXISTING
LOADING AREAS REQUIRED = 1
LOADING AREAS PROVIDED = 5 (12'x25')

BENCH MARK:
FRONT BOLT OF HYDRANT AT CORNER OF MORTON STREET & TARALLI TERRACE
ELEVATION = 155.31 (U.S.C. & G.S. DATUM)

10 YEAR FLOOD ELEVATION = 147.2
50 YEAR FLOOD ELEVATION = 150.5
100 YEAR FLOOD ELEVATION = 151.5

REV. 10-7-85

LEACHING BASIN DESIGN ~ 50 YEAR STORM
D.A.: 0.18 ACRES, C = 0.90, L = 8.1, Q = 1.31 CFS
RUNOFF INCHES: 5.85, Vc: (0.18) (5.85)/12 = 0.088 A.F. = 3822 CF/DAY
PEAK DISCHARGE: 1.31 CFS, LWT W/3' STONE: 2πRH = 2262.2
DEPTH: 2 (1.25/12) (0.12) = 2.83 CF/MIN × 60 = 169.6 CF/HR × 24 = 4071 CF/DAY

USE 1, 6' DEEP, 6' DIA. LEACHING BASIN W/3' STONE

DESIG. 2 FEET/SEC 50 YEAR STORM	TO INLET	INC. ACRES	TOTAL ACRES	"C"	TO INLET (MIN.)	PIPE (MIN.)	I	Q (CFS)	DIA. (INS)	SLOPE FT/FT	n	Q FULL CFS	V FPS	SLOPE %	FALL (FT.)	INVERT UPPER END	INVERT LOWER END
1	2	—	0.06	0.95	5.0	0.2	8.1	0.46	12"	0.0135	0.013	4.2	5.3	7.4	1.00	145.00	144.00
2	3	0.35	0.41	0.90	5.2		7.9	2.92	12"	0.0850	0.013	5.1	7.2	40	1.00	144.00	143.00

REV. 10-7-85

SITE PLAN OF LAND

FRAMINGHAM, MASS.

APPLICANT : WAYNE L. HANSEN
64 WAVERLY ST., FRAMINGHAM, MA
SCALE : 1"=20'
FEBRUARY 3, 1984

JAMES V. MERLONI
REG. PROF. ENGINEER

JOSEPH R. SULLIVAN
REGISTERED LAND SURVEYOR

MacCARTHY & SULLIVAN ENGINEERING INC.
81 SPEEN ST., NATICK, MASS.

DESIGN BY:	DRAWN BY:	CHKD. BY:	
PJS	PJS	JRS	DWG. NO. 26,348

26,348

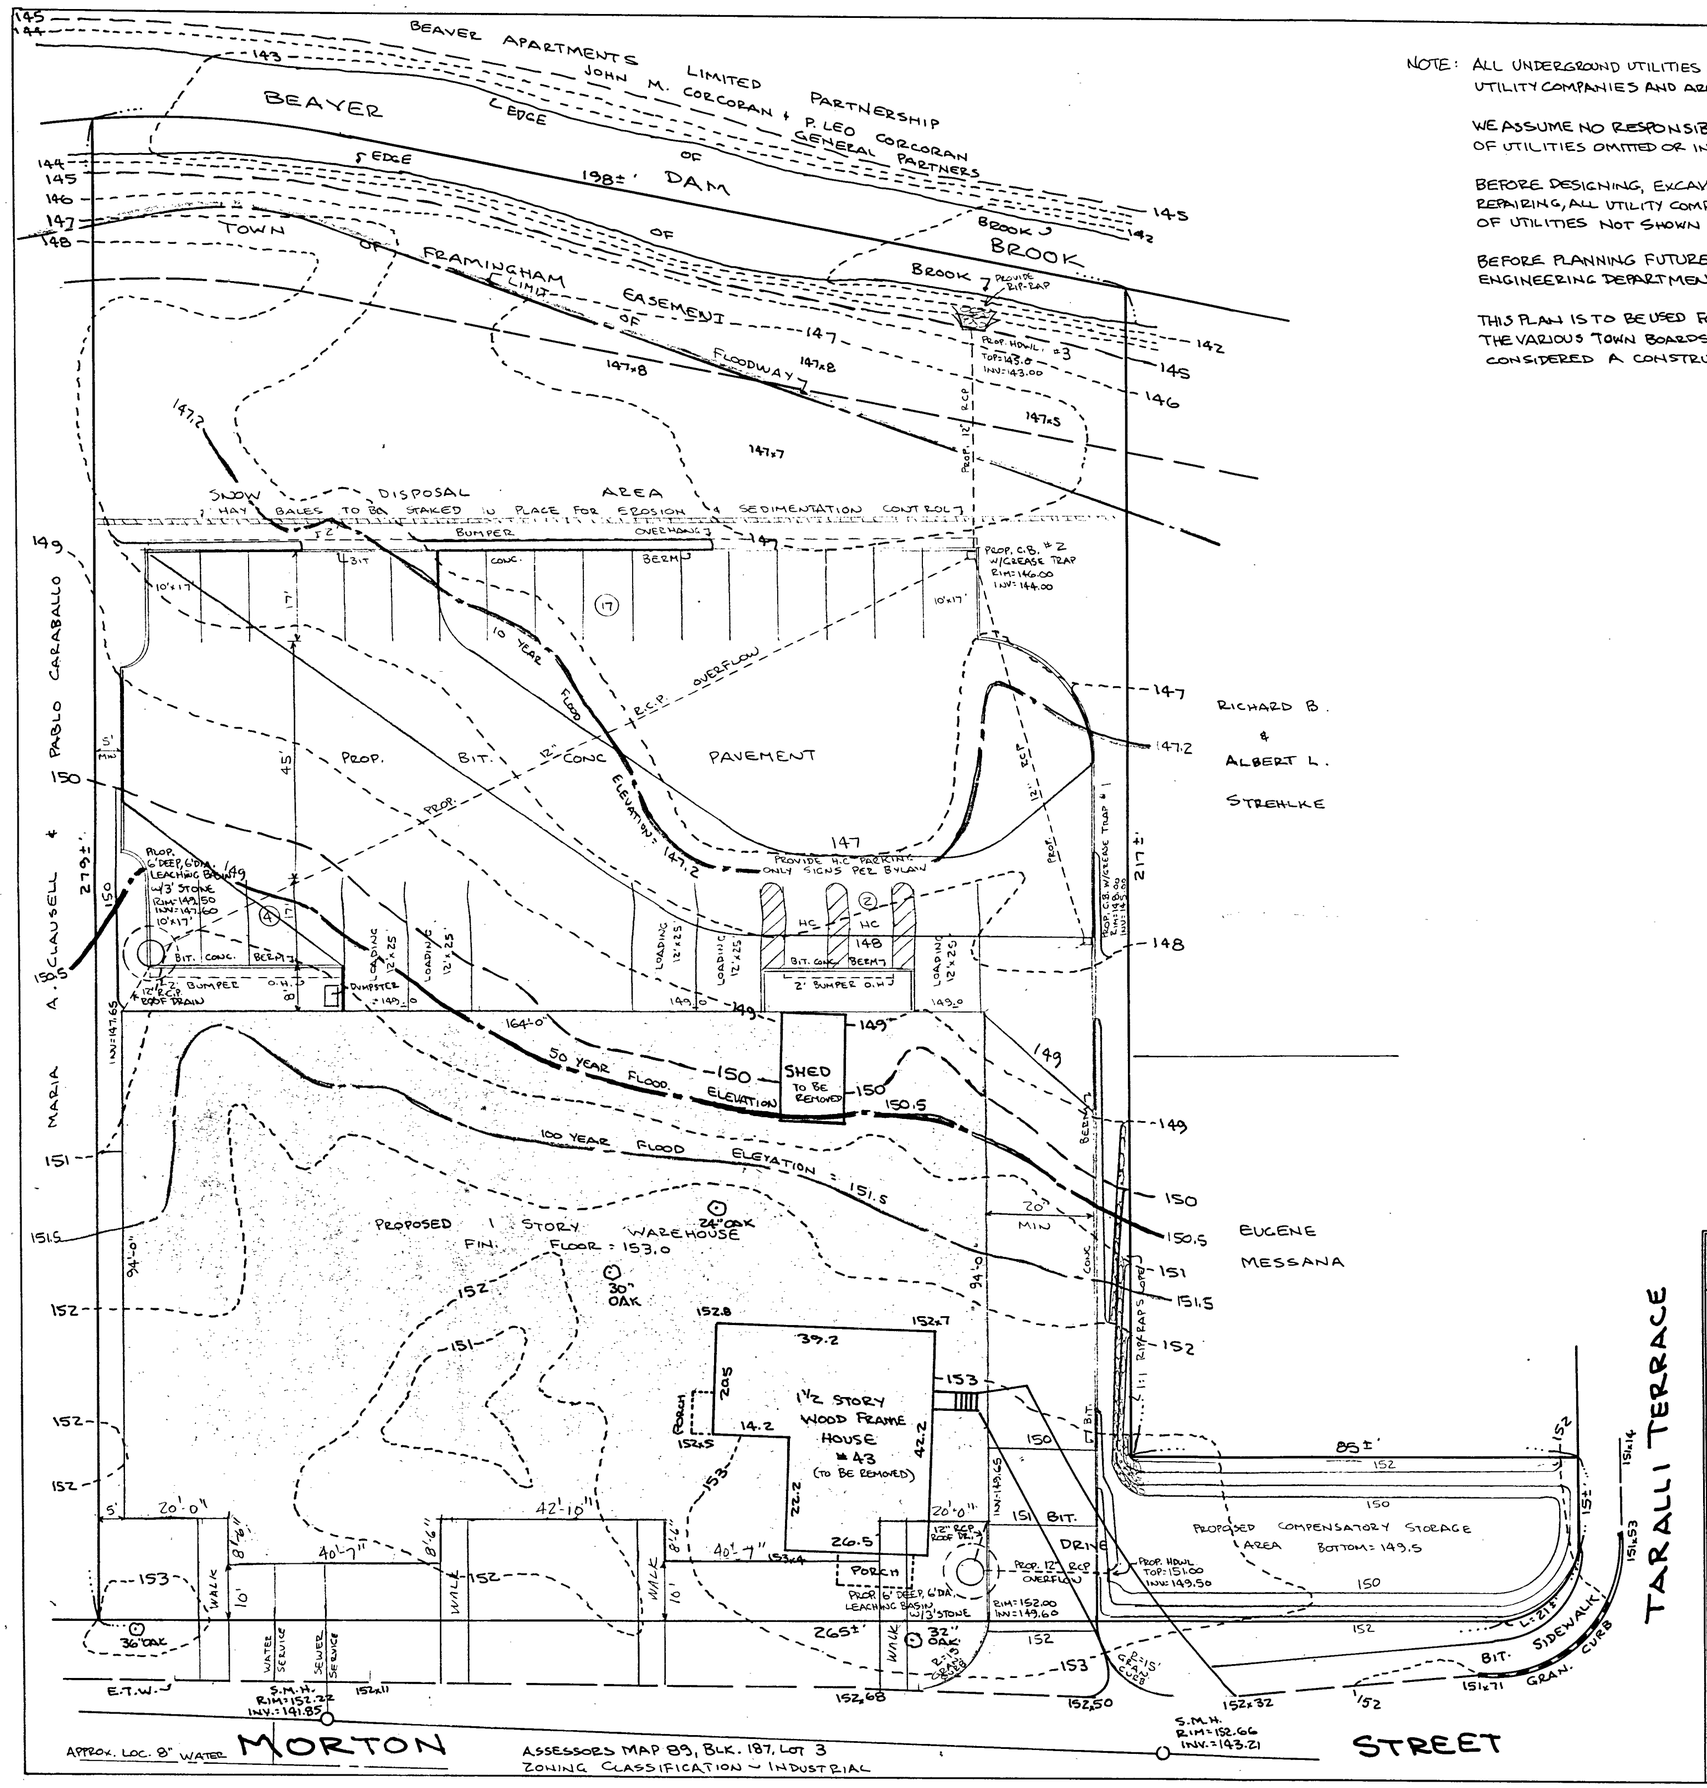

ASSESSORS MAP 89, BLK. 187, LOT 3
ZONING CLASSIFICATION ~ INDUSTRIAL

NOTE: ALL UNDERGROUND UTILITIES SHOWN WERE COMPILED ACCORDING TO AVAILABLE RECORDS FROM THE VARIOUS UTILITY COMPANIES AND ARE APPROXIMATE ONLY. ACTUAL LOCATIONS MUST BE MADE IN THE FIELD.

WE ASSUME NO RESPONSIBILITY FOR DAMAGES INCURRED AS A RESULT OF UTILITIES OMITTED OR INACCURATELY SHOWN.

BEFORE DESIGNING, EXCAVATING, BLASTING, INSTALLING, BACKFILLING, GRADING, PAVEMENT RESTORATION OR REPAIRING, ALL UTILITY COMPANIES, PUBLIC AND PRIVATE, MUST BE CONTACTED INCLUDING THOSE IN CONTROL OF UTILITIES NOT SHOWN ON THIS PLAN. SEE CHAPTER 370, ACTS OF 1963, MASS.

BEFORE PLANNING FUTURE CONNECTIONS, THE APPROPRIATE PUBLIC UTILITY ENGINEERING DEPARTMENT MUST BE CONSULTED.

THIS PLAN IS TO BE USED FOR OBTAINING APPROVAL FROM THE VARIOUS TOWN BOARDS ONLY AND IS NOT TO BE CONSIDERED A CONSTRUCTION PLAN.

AREA OF LOT = 53,900± SQ.FT.
AREA OF BUILDING = 16,105 SQ.FT.
% BUILDING COVERAGE = 29.9%
ALLOWABLE FLOOR AREA = 26,950 SQ.FT.
GROSS FLOOR AREA = 16,105 SQ.FT.
MAX. NO. OF EMPLOYEES AT ONE TIME = 15
PARKING REQUIRED = 15 SPACES
PARKING PROVIDED = 23 SPACES
TYPICAL PARKING SPACE SIZE:
9'x19' & 10'x19' WHERE END STALLS RESTRICTED BY CURBING
MINIMUM DRIVEWAY WIDTH = 20'
AREA OF PARKING AREA = 15,700± SQ.FT.
OPEN SPACE REQUIRED BY PARKING BYLAW = 1570 SQ.FT.
OPEN SPACE REQUIRED BY ZONING BYLAW = 1610 SQ.FT.
OPEN SPACE PROVIDED = 21,500± SQ.FT.
TREES REQUIRED = 2
TREES PROVIDED = 2 EXISTING
LOADING AREAS REQUIRED = 1
LOADING AREAS PROVIDED = 5 (12'x25')

BENCH MARK:
FRONT BOLT OF HYDRANT AT CORNER OF MORTON STREET & TARALLI TERRACE
ELEVATION = 155.31 (U.S.C. & G.S. DATUM)

10 YEAR FLOOD ELEVATION = 147.2
100 YEAR FLOOD ELEVATION = 151.5

REV 10-7-85

LEACHING BASIN DESIGN ~ 50 YEAR STORM
D.A.: ONBAGRES C=0.90 L=B.1 Q=1.31 CFS
RUNOFF INCHES = 5.85 V_R = (0.18)(5.85)/12 = 0.088 A.F. = 3822 CF/DAY
PERMEABILITY = 1.25 INX/HR POROSITY = 12%
USE 1, 6' DEEP, 6' DIA. LEACHING BASIN w/3' STONE: 2 TRENCHES: 226.2
226.2 (1.25/12)(0.12) = 2.83 CF/HR/MIN x 60 = 169.6 CF/HR. A24 = 4071 CF/DAY

DESIGN FREQUENCY 50 YEAR STORM	EL. OF A	TO	INC. ACRES	TOTAL ACRES	"C"	TIME OF CONC. (MIN)	TIME OF FLOW (MIN)	I	Q (CFS)	DIA. (INX)	SLOPE FT/FT	n	Q1 CFS	V FPS	LENGTH	FALL (FT)	INVERT EXTREME END	INVERT LOWEST END
	1	2	–	0.06	0.95	5.0	0.2	8.1	0.46	12"	0.0135	0.013	4.2	5.3	74	1.00	145.00	144.00
	2	3	0.35	0.41	0.90	5.2		7.9	2.92	12"	0.0250	0.013	5.7	7.2	40	1.00	144.00	143.00

SITE PLAN OF LAND

FRAMINGHAM, MASS.

APPLICANT : WAYNE L. HANSEN
64 WAVERLY ST., FRAMINGHAM, MA
SCALE : 1"=20'
FEBRUARY 3, 1984

JAMES V. MERLONI
REG. PROF. ENGINEER

JOSEPH R. SULLIVAN
REGISTERED LAND SURVEYOR

MacCARTHY & SULLIVAN ENGINEERING INC.
81 SPEEN ST., NATICK, MASS.

DESIGN BY:	DRAWN BY:	CHKD. BY:	DWG. NO.
PJS	PJS	JRS	26,348

26,348

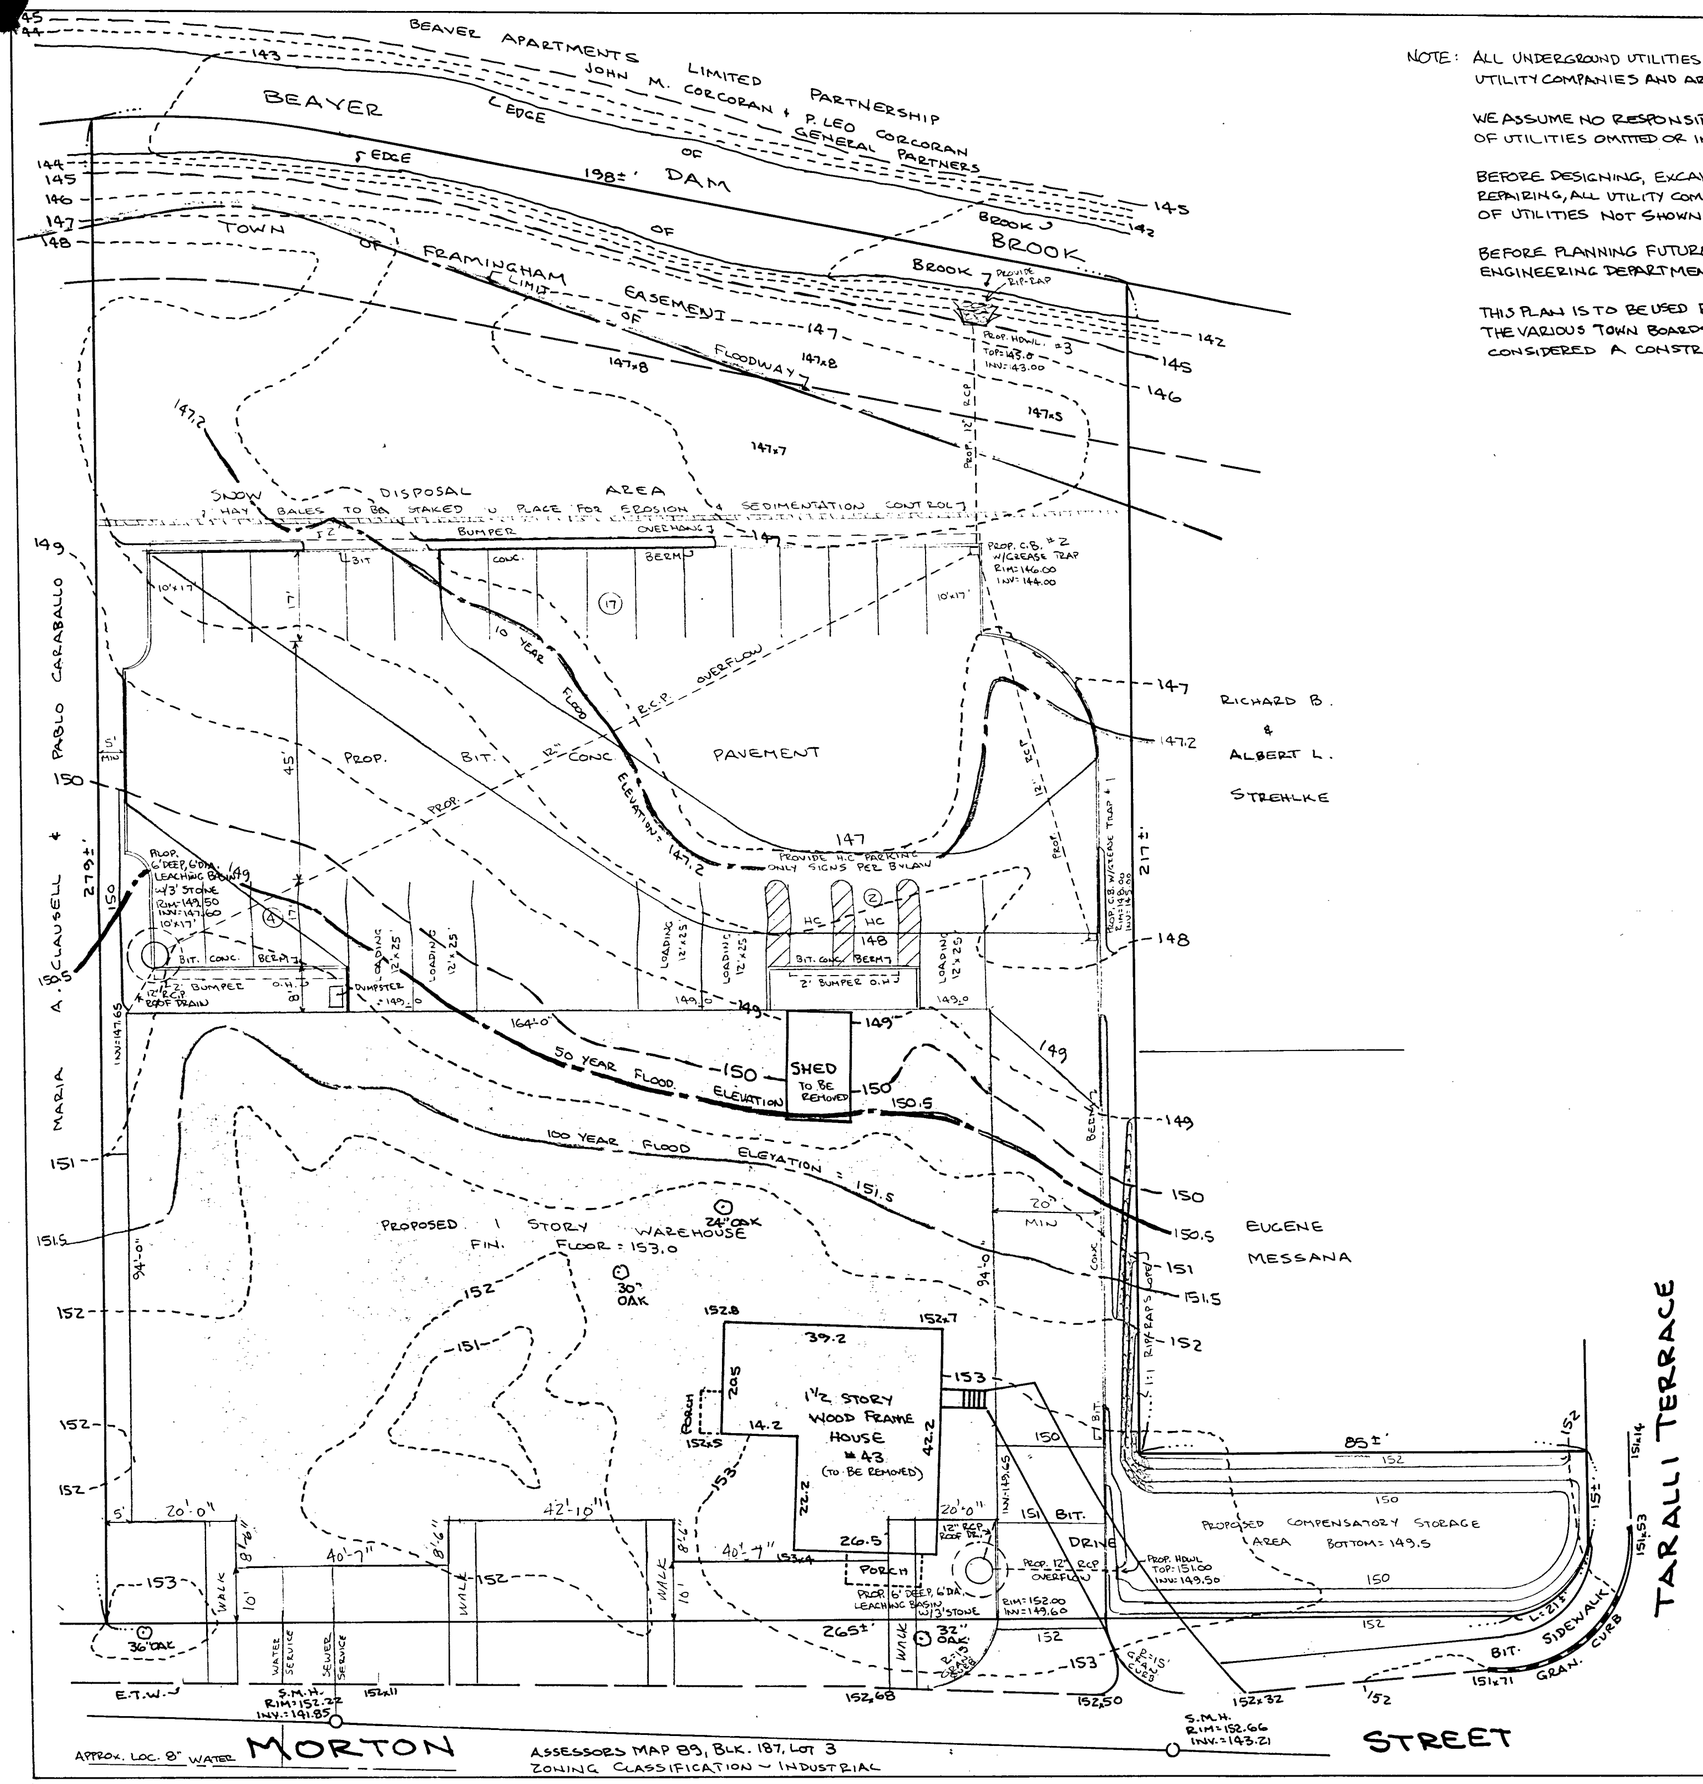

NOTE: ALL UNDERGROUND UTILITIES SHOWN WERE COMPILED ACCORDING TO AVAILABLE RECORDS FROM THE VARIOUS UTILITY COMPANIES AND ARE APPROXIMATE ONLY. ACTUAL LOCATIONS MUST BE MADE IN THE FIELD.

WE ASSUME NO RESPONSIBILITY FOR DAMAGES INCURRED AS A RESULT OF UTILITIES OMITTED OR INACCURATELY SHOWN.

BEFORE DESIGNING, EXCAVATING, BLASTING, INSTALLING, BACKFILLING, GRADING, PAVEMENT RESTORATION OR REPAIRING, ALL UTILITY COMPANIES, PUBLIC AND PRIVATE, MUST BE CONTACTED INCLUDING THOSE IN CONTROL OF UTILITIES NOT SHOWN ON THIS PLAN. SEE CHAPTER 370, ACTS OF 1963, MASS.

BEFORE PLANNING FUTURE CONNECTIONS, THE APPROPRIATE PUBLIC UTILITY ENGINEERING DEPARTMENT MUST BE CONSULTED.

THIS PLAN IS TO BE USED FOR OBTAINING APPROVAL FROM THE VARIOUS TOWN BOARDS ONLY AND IS NOT TO BE CONSIDERED A CONSTRUCTION PLAN.

AREA OF LOT = 53,900± SQ. FT.
AREA OF BUILDING = 16,105 SQ. FT.
% BUILDING COVERAGE = 29.9%
ALLOWABLE FLOOR AREA = 26,950 SQ. FT.
GROSS FLOOR AREA = 16,105 SQ. FT.
MAX. NO. OF EMPLOYEES AT ONE TIME = 15
PARKING REQUIRED = 15 SPACES
PARKING PROVIDED = 23 SPACES
TYPICAL PARKING SPACE SIZE:
9'x19' & 10'x19' WHERE END STALLS RESTRICTED BY CURBING
MINIMUM DRIVEWAY WIDTH = 20'
AREA OF PARKING AREA = 15,700± SQ. FT.
OPEN SPACE REQUIRED BY PARKING BYLAW = 1570 SQ. FT.
OPEN SPACE REQUIRED BY ZONING BYLAW = 1610 SQ. FT.
OPEN SPACE PROVIDED = 21,500± SQ. FT.
TREES REQUIRED = 2
TREES PROVIDED = 2 EXISTING
LOADING AREAS REQUIRED = 1
LOADING AREAS PROVIDED = 5 (12'x25')

BENCH MARK:
FRONT BOLT OF HYDRANT AT CORNER OF MORTON STREET & TARALLI TERRACE
ELEVATION = 155.31 (U.S.C. & G.S. DATUM)

10 YEAR FLOOD ELEVATION = 147.2
50 YEAR FLOOD ELEVATION = 150.5
100 YEAR FLOOD ELEVATION = 151.5

REV. 10-7-85

LEACHING BASIN DESIGN ~ 50 YEAR STORM
D.A. = 0.18 ACRES, C = 0.95, L = B.1, Q = 1.31 CFS
PEAK RUNOFF = 1.25 (1.25/12) x 43,560 = 4,356 CF/HR
LEACHING BASIN: 2' x 2' x 3' STONE; 2' x 2' x H = 2262.2
USE 1, 6' DEEP, 6' DIA. LEACHING BASIN w/3' STONE; 2' x 2' x H = 2262.2
(1.25/12)(0.12) = 2.83 CF/MIN x 60 = 169.6 CF/HR x 24 = 4071 CF/DAY

	T	O	INC. ACRES	TOTAL ACRES	"C"	TO INLET (MIN.)	PIPE (MIN.)	I	Q (CFS)	DIA. (IN.)	SLOPE FT/FT	n	Q1 (CFS)	V (FPS)	HL	FALL (FT.)	INVERT UPPER END	INVERT LOWER END
	1	2	–	0.06	0.95	5.0	0.2	8.1	0.46	12"	0.0135	0.013	4.2	5.3	7.4	1.00	145.00	144.00
DESIGN FREQUENCY 50 YEAR STORM	2	3	0.35	0.41	0.90	5.2		7.9	2.92	12"	0.0250	0.013	5.1	7.2	4.0	1.00	144.00	143.00

SITE PLAN OF LAND 653-0680

FRAMINGHAM, MASS.

APPLICANT : WAYNE L. HANSEN
64 WAVERLY ST., FRAMINGHAM, MA
SCALE : 1"=20'
FEBRUARY 3, 1984

JAMES V. MERLONI
REG. PROF. ENGINEER

JOSEPH R. SULLIVAN
REGISTERED LAND SURVEYOR

MacCARTHY & SULLIVAN ENGINEERING INC.
81 SPEEN ST., NATICK, MASS.

DESIGN BY:	DRAWN BY:	CHKD. BY:	
PJS	PJS	JRS	DWG. NO. 26,348